
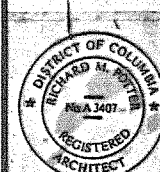
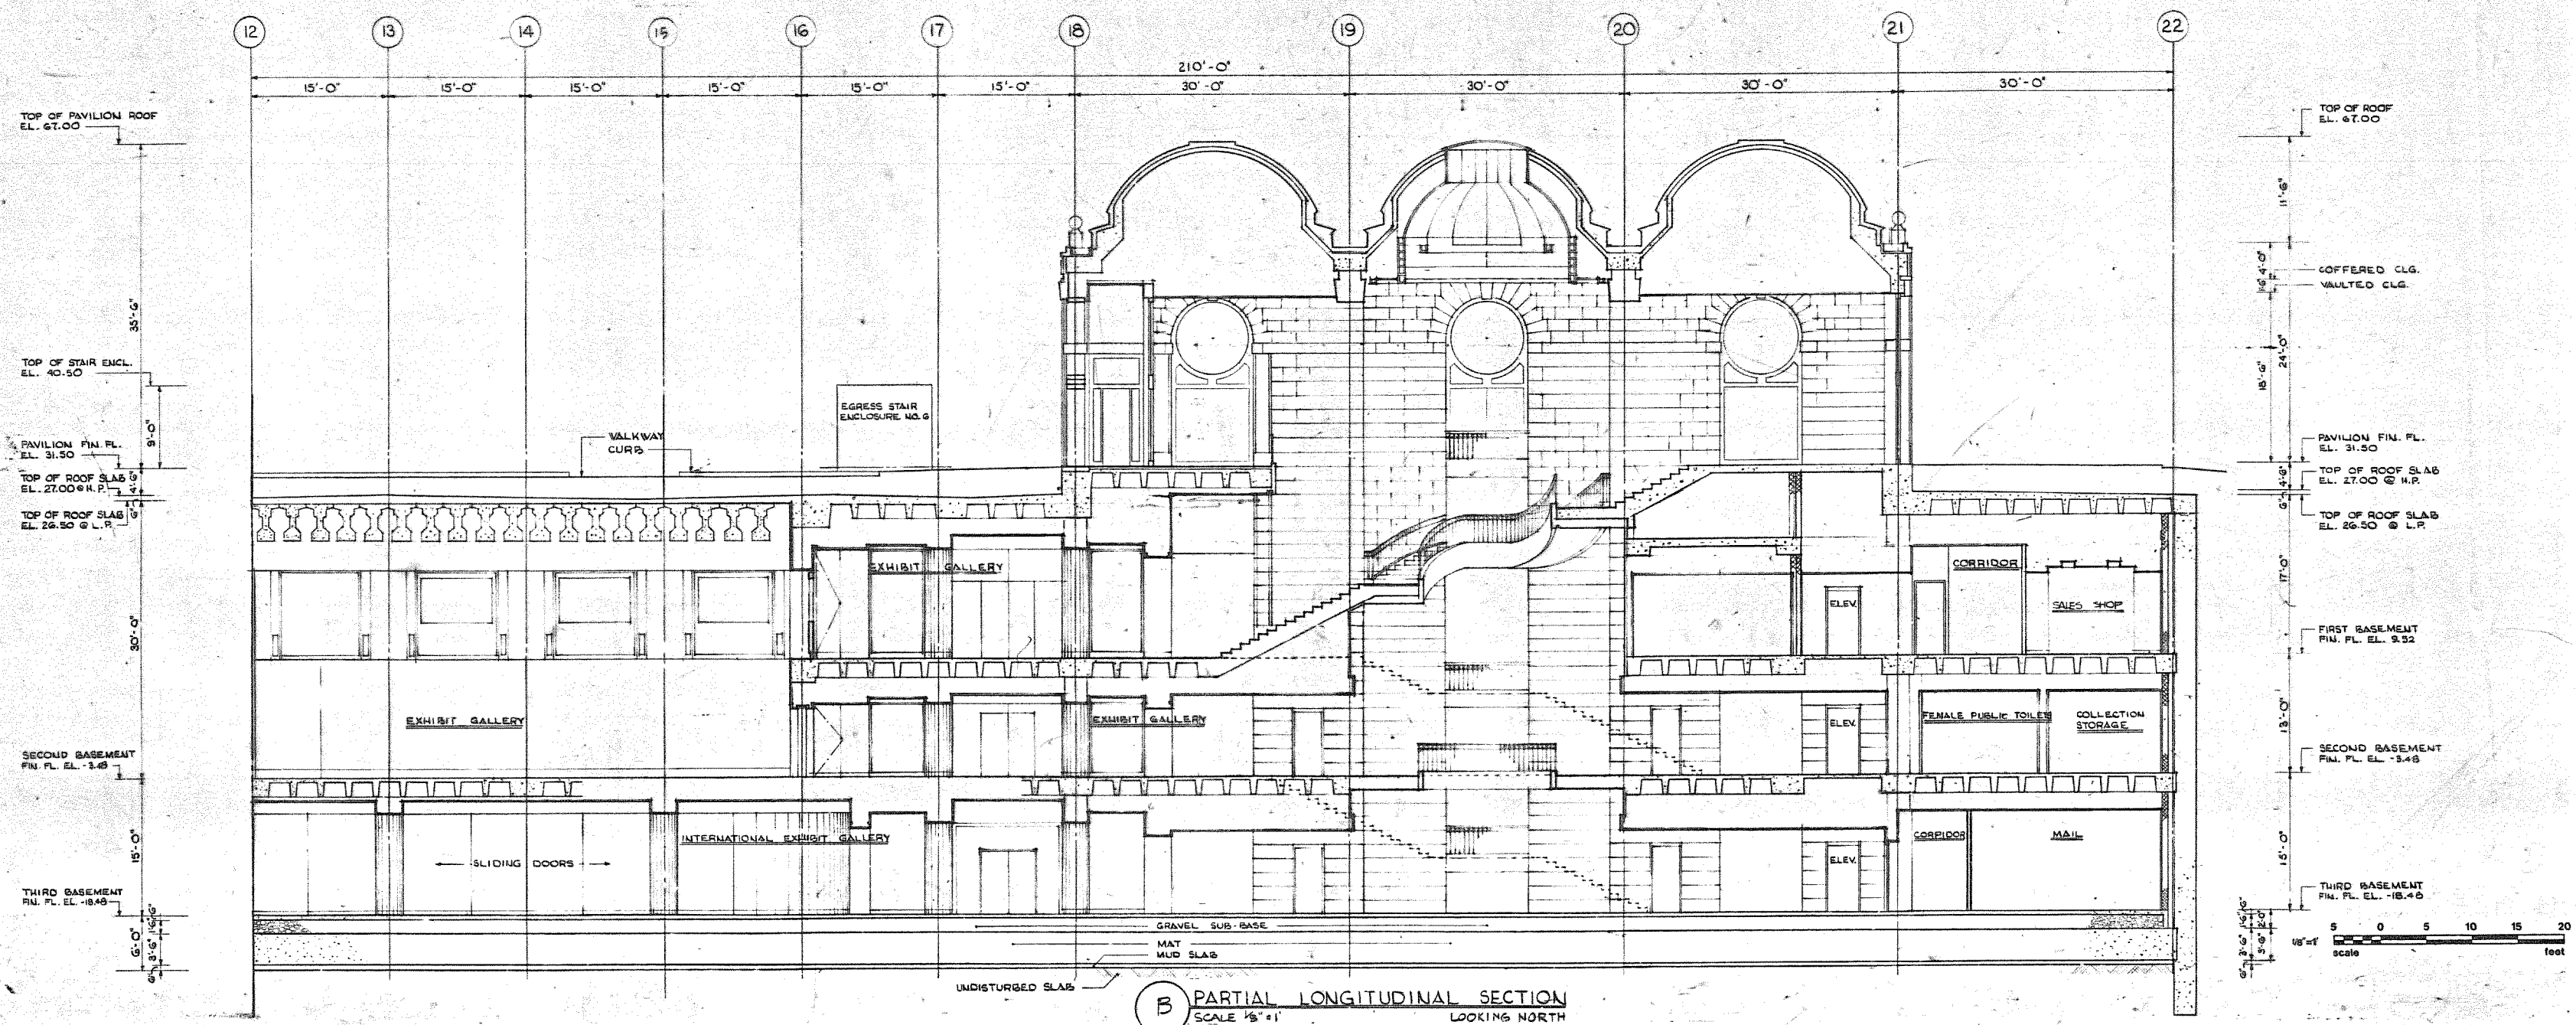


GENERAL NOTES

1. FOR LOCATION OF BLDG. SECTIONS
SEE DWG. NOS. 3-001 TO 3-020

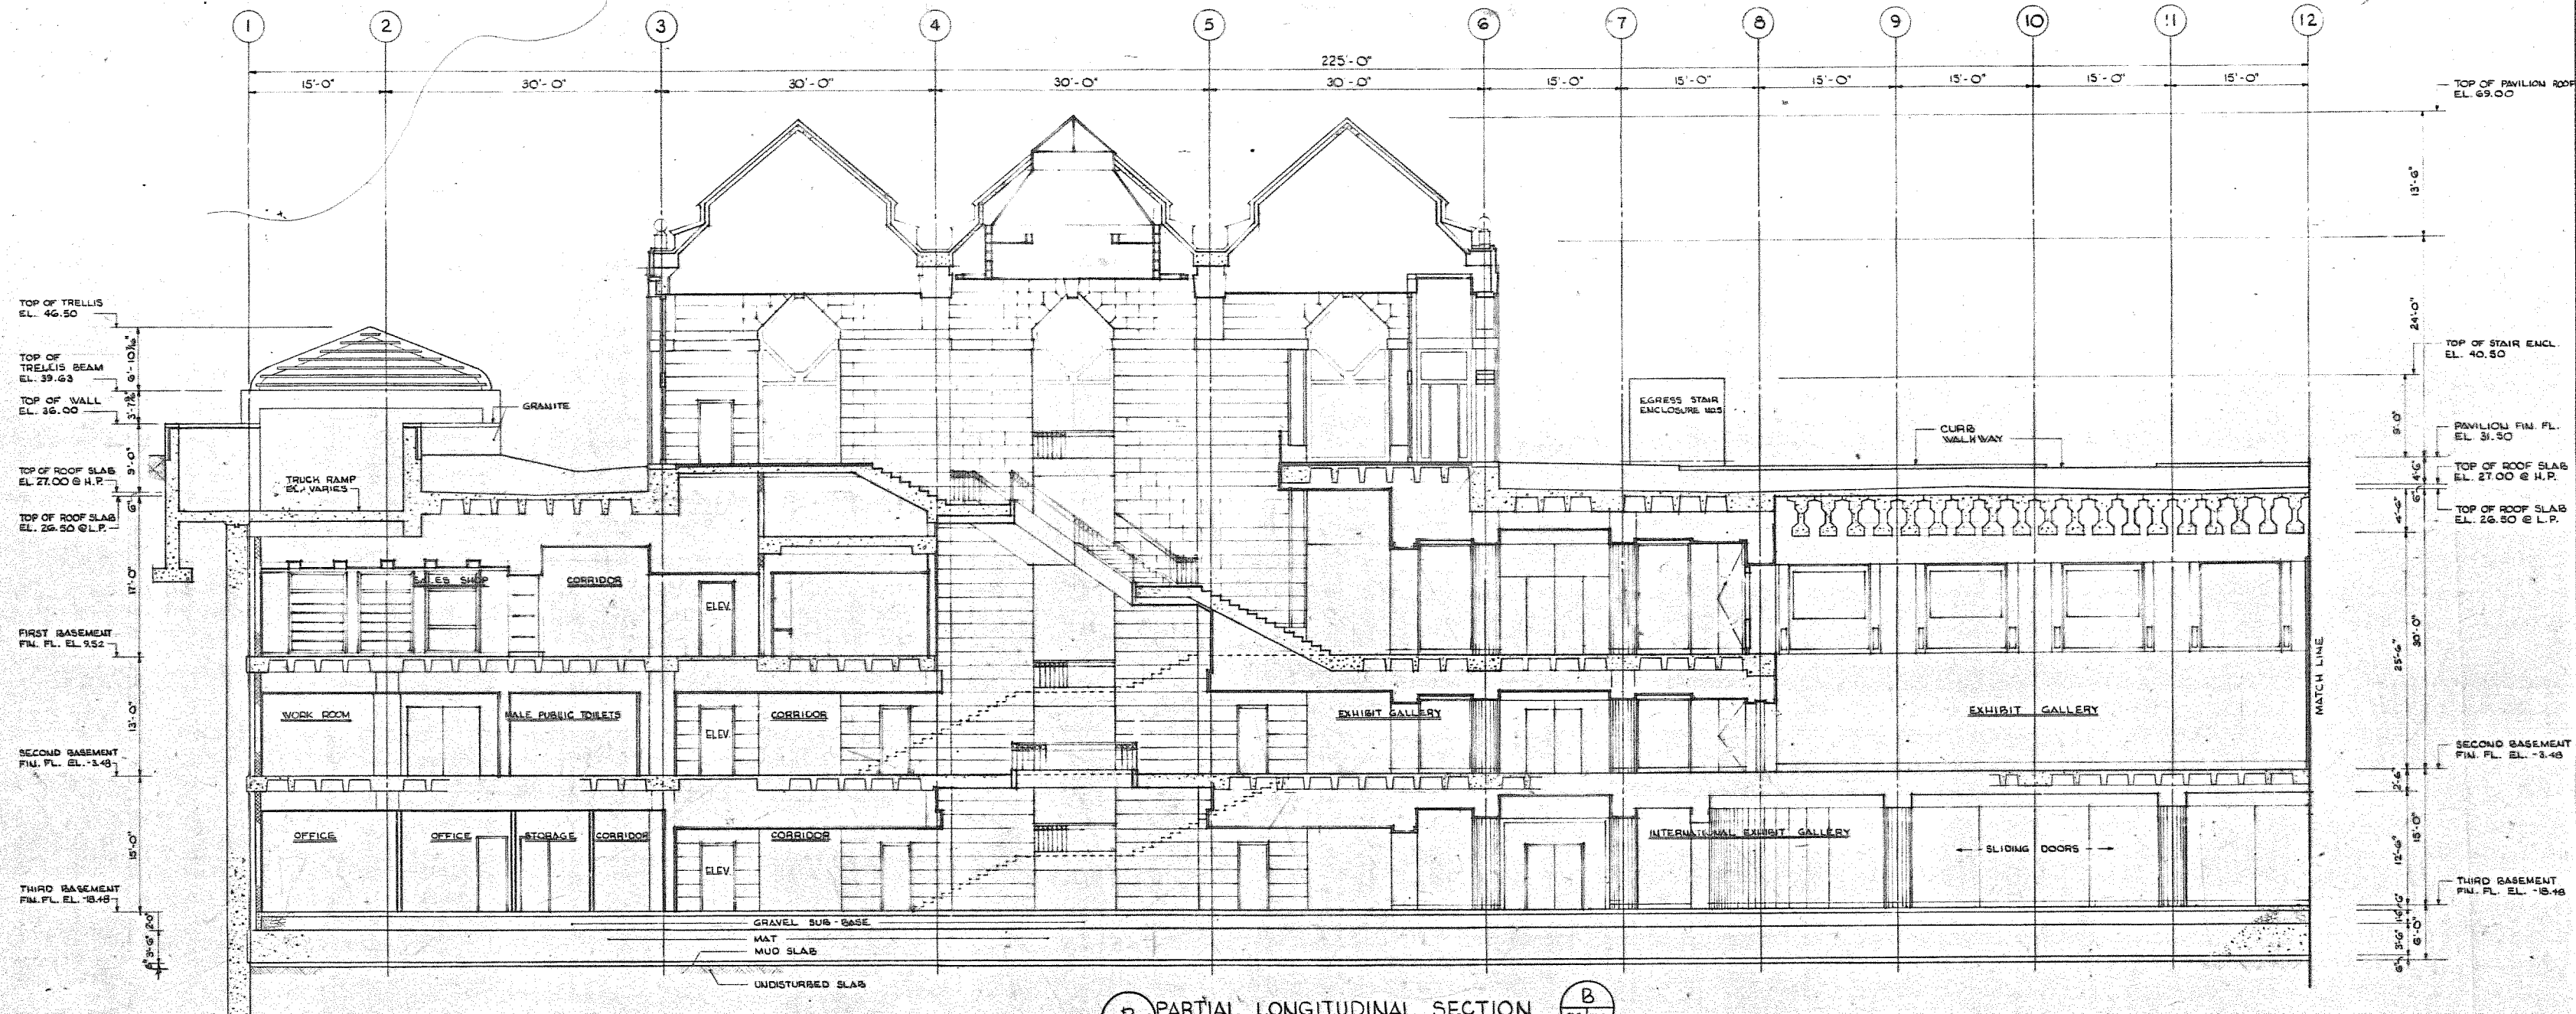

REVISION		Date
SHEPLEY BULFINCH RICHARDSON AND ABBOTT ARCHITECTS ONE COURT STREET BOSTON MASSACHUSETTS 02108 617-742-1400		
APPROVED	ARCHITECTURAL	STRUCTURAL
GENERAL SERVICES ADMINISTRATION PUBLIC BUILDINGS SERVICE - NATIONAL CAPITAL REGION		
BUILDING	NAME SMITHSONIAN / SOUTH QUADRANGLE	
PROJECT	ADDRESS INDEPENDENCE AVE. & 10th STREET, S.W.	
	CITY WASHINGTON STATE D.C.	
	NUMBER NDC - 00001	
	DESCRIPTION	
	DRAWN BY DATE 11/26/93	
	TITLE LONGITUDINAL SECT. - B	
	TYPE ARCHITECTURAL	
	NUMBER 4 - 002	
	TYPE SERIES SEQUENCE	
A-E	CONTRACT NUMBER	00-119 - 00007
CONSTRUCTION	CONTRACT NUMBER	00-119 - 00007